


LABOR AND MATERIALS

| | | | | |
|----|------------------------------|--|---------|----|
| 1 | Copper Lead | Connection | 3/4" | \$ |
| 1 | Curb | Cock Valve T. S. & V. | 3/4 in. | \$ |
| 1 | Service box - Old returned | Short 3 1/2 x 4 1/2 Long 4 1/2 x 5 1/2 Buff or Rdway | | \$ |
| 25 | Ft. | 3/4 in. { Copper G. I. C. I. } | Pipe at | \$ |
| | Nipples | in. at | | \$ |
| | Bushings | to in. at | | \$ |
| | Red'g Inc'g | Coupl'gs to in. at | | \$ |
| | Union | in. at | | \$ |
| | Meter | in. at | | \$ |
| | Lead Joints | at | | \$ |
| | Compound Joints | at | | \$ |
| | Maintenance Foreman | | | \$ |
| | Hrs. Water Maint. Man-1 | at | | \$ |
| | Hrs. Water Maint. Man-2 | at | | \$ |
| | Hrs. Garage Foreman | at | | \$ |
| | Hrs. Labor | at | | \$ |
| | Hrs. Compressor | at | | \$ |
| | Compensation Ins. at \$ | per C. | | \$ |
| | Trucking | | | \$ |
| | Pav't Patch | | | \$ |
| | Tap by Gifford & Co. 8-9-61. | | | \$ |
| | O'head | | | \$ |
| | | | | \$ |

St. Uncas
Pl. 38
Ave. No. 38

Name of Owner Paul H. Wakeley

Labor and Mat'l. Report Aug. 9 1961

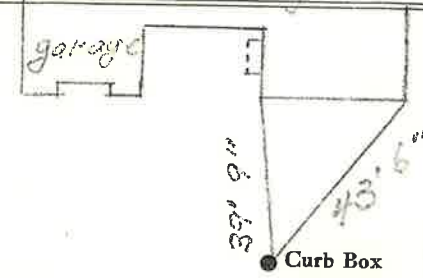

6" C.I. Main Elev. of Main at tap 5 1/2'
Gate at ● Gate at ●

25' to main
3/4" copper ● Curb Box

TAX ID # 303.9-16-1