


LABOR AND MATERIALS

1	Copper	} Connection	3/4"	\$	
	Lead				
1	Curb	} Cock Valve T.S. & V.	3/4 in. Oriseal.	\$	
1	Service box				
Old returned					
		} Short 3 1/2 x 4 1/2 Long 4 1/2 x 5 1/2 Buff or Rdway		\$	
28	Ft. 3/4 in.				
		} Copper G.I. C.I.	} Pipe at	\$	
	Nipples				
	in. at				
	Bushings	to	in. at	\$	
	Red'g	} Coupl'gs.	to	in. at	\$
	Inc'g				
	Union	in. at	\$		
	Meter	in. at	\$		
	Lead Joints	at	\$		
	Compound Joints	at	\$		
	Maintenance Foreman	at	\$		
	Hrs. Water Maint. Man-1	at	\$		
	Hrs. Water Maint. Man-2	at	\$		
	Hrs. Garage Foreman	at	\$		
	Hrs. Labor	at	\$		
	Hrs. Compressor	at	\$		
	Compensation Ins. at \$	per C	\$		
	Trucking		\$		
	Pav't Patch		\$		
	Tap by Gifford & Co.		\$		
	3-8-69.		\$		
	O'head		\$		

St. Pt. Ave. No. 42
 Uncas

Name of Owner
 Hollis Keysey

Labor and Mat'l. Report Mar. 8 1969

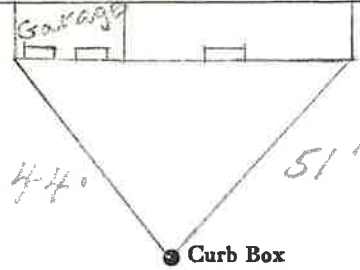

6" Main Elev. of Main at tap 5'

Gate at • Gate at •

28' to MAIN

3/4" copper • Curb Box

TAX ID # 303.9-16-3