


LABOR AND MATERIALS

1	Copper	Connection	3/4"	\$
1	Lead			\$
1	Curb	Cock Valve F.S. & V.	3/4" in.	\$
1	Service box	Short 3 1/2 x 4 1/2		\$
	Old returned	Long 4 1/2 x 5 1/2		\$
		Buff or Rdway		\$
27	Ft. 3/4 in.	Copper G.I. Pipe at	119	\$
	Nipples	in. at		\$
	Bushings	to in. at		\$
	Red'g Inc'g	Coupl'gs to in. at		\$
	Union	in. at		\$
	Meter	in. at		\$
	Lead Joints	at		\$
4	Compound Joints	at		\$
	Maintenance Foreman	19.37		\$
	Hrs. Water Maint. Man	1 at		\$
4	Hrs. Water Maint. Man	2 at 1.613		\$
	Hrs. Garage Foreman	1.62 at 1.481		\$
8	Hrs. Labor	at 1.30		\$
	Hrs. Compressor	at		\$
	Compensation Ins.	at \$ per C		\$
	Trucking			\$
	Pav't Patch			\$
	Tap by Gifford & Co			\$
		3-25-57		\$
	O'head			\$

St. Urcaas ✓
 Pl. 44
 Ave. No. 44

Name of Owner Kelly

Labor and Mat'l. Report Mar. 25 1957

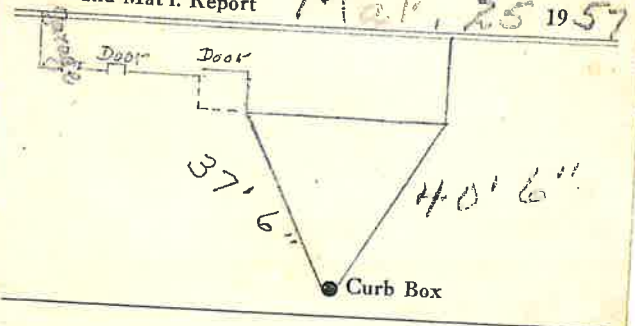

6" Main Elev. of Main at tap 5 1/2'
 Gate at ● Gate at ●

27' to main
3/4" copper ● Curb Box