


LABOR AND MATERIALS

1	Copper	Connection	3/4"	\$
1	Lead	Cock	3/4" or 1/2"	\$
1	Curb	Valve	3/4" in.	\$
		T.S. & V.		\$
1	Service box	Short 3 1/2 x 4 1/2		\$
1	Old returned	Long 4 1/2 x 5 1/2		\$
		Buff. or Rdway		\$
17	Ft. 3/4 in.	Copper	Pipe at	\$
		G.I.		\$
		G.I.		\$
	Nipples	in. at		\$
	Bushings	to in. at		\$
	Red'g			\$
	Inc'g	Coupl'gs. to in. at		\$
	Union	in. at		\$
	Meter	in. at		\$
	Lead Joints	at		\$
	Compound Joints	at		\$
	Maintenance Foreman			\$
	Hrs. Water Maint. Man-1	at		\$
	Hrs. Water Maint. Man-2	at		\$
	Hrs. Garage Foreman	at		\$
	Hrs. Labor	at		\$
	Hrs. Compressor	at		\$
	Compensation Ins. at \$	per C		\$
	Trucking			\$
	Pav't Patch			\$
	Tap by Gifford & Co.			\$
	4-23-64.			\$
	O'head			\$
				\$

St. \_\_\_\_\_  
 Pl. \_\_\_\_\_  
 Ave. No. 45  
 Name of Owner John Wheeler.

Labor and Mat'l. Report Apr. 23 1964

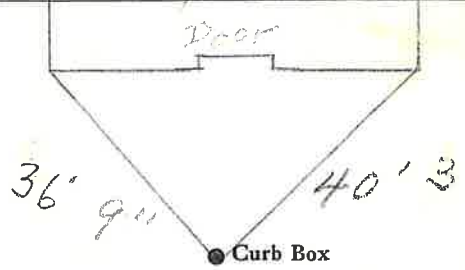

6" C.I. Main Elev. of Main at tap 4 1/2'

Gate at • Gate at •

17' to main

3/4 copper • Curb Box