




SANFORD ST. (7)

UNCAS ST. (244)

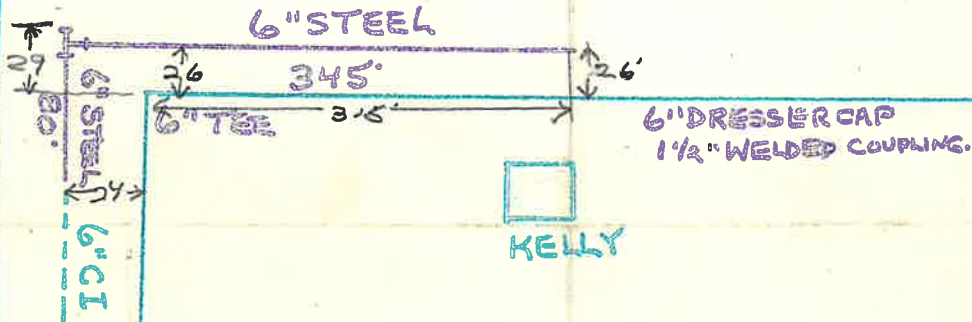

CITY OF GLENS FALLS 8001
COUNTY-WARREN
ZONE 725-209C

PROJECT 69-25

GLENS FALLS DISTRICT
IN GAS MAIN UNCAS ST
10-26-56 R.C.C.