

LABOR AND MATERIALS

1. Copper Connection $\frac{3}{4}$	\$ 2.87
1. Lead } Cock	
1. Curb } Valve } $\frac{3}{4}$ in.....	\$ 3.67
1. Service box } Short $3\frac{1}{2}$ X $4\frac{1}{2}$ }	
Old returned } Long $4\frac{1}{2}$ X $5\frac{1}{2}$ }	4.68
25 $\frac{3}{4}$ Ft. $\frac{3}{4}$ in. } Copper } Pipe at 37.....	\$ 8.00
..... Nipples..... in. at.....	\$
..... Bushings..... to..... in. at.....	\$
..... Red'g }	
..... Inc'g } Coupl'gs..... to..... in. at.....	\$
..... Union..... in. at.....	\$
..... Meter..... in. at.....	\$
..... Lead Joints at.....	\$
..... Compound Joints at.....	\$
..... Hrs. Water Maint. Man—1 at.....	\$
4 Hrs. Water Maint. Man—2 at 1.02.....	\$ 4.08
6 Hrs. Labor—..... at..... 91.....	\$ 5.46
..... Hrs. Labor—..... at.....	\$
..... Hrs. Compressor at.....	\$
..... Compensation Ins. at \$ 2.18 per C.....	\$ 1.21
..... Trucking.....	\$ 2.00
..... Pav't Patch.....	\$
..... <i>Truck by Reg. name</i>	\$
..... O'head.....	\$
	\$ 30.92

54

219
St. 407th
PI- 69
Ave. No.


Uncas

Name of Owner

Gilbert Froncato

Labor and Mat'l. Report

June 10 1949

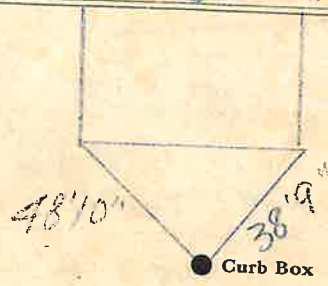

6 Main

Elev. of Main at tap 5

Gate at ●

● Gate at

25' to main

$\frac{3}{4}$ copper

● Curb Box

TAX ID # 303.13-12-7