

LABOR AND MATERIALS

1	Copper Lead	} Connection	3/4	in.	\$ 1.35
1	Curb	} Cock Valve	3/4	in.	\$ 1.80
		} F. S. & V.			
1	Service Box	} Short 3 1/2 x 4 1/2 Long 4 1/2 x 5 1/2 Buffer Rdway			\$ 1.70
	Old returned				
8	Ft.	} Copper Galv. Iron Cast Iron		Pipe at 18	\$ 1.44
	3/4 in.				
	Nipples			in. at	\$
	Bushings			to in. at	\$
	Red'g Inc'g	} Couplings		to in. at	\$
	Union				in. at
	Meter			in. at	\$
	Lead Joints at				\$
	Leadite Joints at				\$
	Hrs. Foreman at				\$
	Hrs. Chauffeur at				\$
	Hrs. Tapper at				\$
	Hrs. Labor at				\$
	Hrs. Labor at				\$
	Hrs. Compressor at				\$
	Compensation Ins.				\$ 1-
	Trucking				\$
	Builders Use of Water				\$
	Tap by Hessel				\$
					\$
					\$
					\$ 7.49

8 1 1941

20
St. hot
Pl. -
Ave. No. 65

Name of Owner


Ball

Labor and Mat'l. Report

Sept 18 1941

10 or 10

See
Below

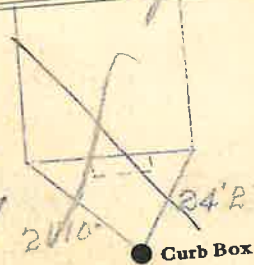

Main

Elev. of
Main at tap

Gate at ● TAX ID # 303.13-11-1 ● Gate at

81
form in

