

LABOR AND MATERIALS

1	Copper Lead	} Connection $\frac{3}{4}$		\$ 1.35
1	Curb	} Cock Valve T. S. & V.	$\frac{3}{4}$ in.	\$ 1.80
1	Service Box Old returned	} Short $3\frac{1}{2} \times 4\frac{1}{2}$ Long $4\frac{1}{2} \times 5\frac{1}{2}$ Buffer Rdway		\$ 1.70
8	Ft. $\frac{3}{4}$ in.		} Copper Galv Iron Cast Iron	\$ 1.44
				Pipe at 18
	Nipples		in. at	\$
	Bushings		to in. at	\$
	Red'g Inc'g	} Couplings	to in. at	\$
	Union			in. at
	Meter		in. at	\$
	Lead Joints at			\$
	Leadite Joints at			\$
	Hrs. Foreman at			\$
	Hrs. Chauffeur at			\$
	Hrs. Tapper at			\$
	Hrs. Labor at			\$
	Hrs. Labor at			\$
	Hrs. Compressor at			\$
	Compensation Ins.			\$
	Trucking			\$ 1.00
	Builders Use of Water			\$
	Tapped by Hessel			\$
				\$
				\$
				\$
				\$
				\$ 7.79

Labor & mats included
in estimate

1 3 1941

22

22

St. _____
-Pl- _____
Ave. No. 12


Uncas

Name of Owner

Ball

Labor and Mat'l. Report

Sept 16 1941

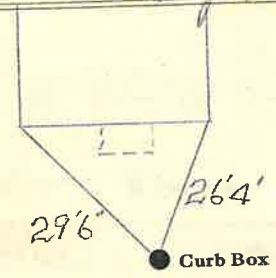

● Curb Box

6 Main

Elev. of
Main at tap 4'

Gate at ●

● Gate at

8' to MAIN

$\frac{3}{4}$ copper

● Curb Box

TAX ID# 303.13-11-2