


LABOR AND MATERIALS

1	Copper	Connection	3/4"	\$
1	Lead	Cock	Oris 1 3/4 in.	\$
1	Curb	Valve	T. S. & V.	\$
1	Service box	Short 3 1/2 x 4 1/2		\$
	Old returned	Long 4 1/2 x 5 1/2		\$
		Buff or Rdway		\$
13	Ft. 3/4"	Copper	Pipe at	\$
		C.I.		\$
		C.I.		\$
	Nipples	in. at		\$
	Bushings	to in. at		\$
	Red'g			\$
	Inc'g	Coupl'gs. to in. at		\$
	Union	in. at		\$
	Meter	in. at		\$
	Lead Joints	at		\$
	Compound Joints	at		\$
	Maintenance Foreman			\$
	Hrs. Water Maint. Man-1	at		\$
	Hrs. Water Maint. Man-2	at		\$
	Hrs. Garage Foreman	at		\$
	Hrs. Labor	at		\$
	Hrs. Compressor	at		\$
	Compensation Ins. at \$	per C		\$
	Trucking			\$
	Pav't Patch			\$
	Tap made Oct 5-64			\$
	By Welby & gang			\$
	O'head			\$

St. Lot 3
 Pl. Uncas St.
 Ave. No. 33

Name of Owner
John Wheeler

Labor and Mat'l. Report Oct 5 1964

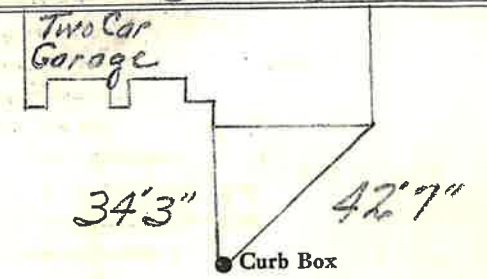

6" Main Elev. of Main at tap 4'

Gate at ● Gate at

13' to main

3/4" Copper ● Curb Box

TAX ID # 303.13-6-5