


LABOR AND MATERIALS

1	Copper Lead	Connection	<u>3/4</u>	\$	
1	Curb	Cock Valve	<u>3/4</u> in. <u>Ori seal.</u>	\$	
		T. S. & V.		\$	
1	Service box	Short $3\frac{1}{2} \times 4\frac{1}{2}$		\$	
	Old returned	Long $4\frac{1}{2} \times 5\frac{1}{2}$		\$	
		Buff or Rdway		\$	
24	Ft. <u>3/4</u> in.	Copper		\$	
		G. I.		\$	
		G. I.		\$	
		Pipe at		\$	
	Nipples	in. at		\$	
	Bushings	to in. at		\$	
	Red'g			\$	
	Inc'g	Coupl'gs. to in. at		\$	
	Union	in. at		\$	
	Meter	in. at		\$	
	Lead Joints at			\$	
	Compound Joints at			\$	
	Maintenance Foreman			\$	
	Hrs. Water Maint. Man-1 at			\$	
	Hrs. Water Maint. Man-2 at			\$	
	Hrs. Garage Foreman at			\$	
	Hrs. Labor at			\$	
	Hrs. Compressor at			\$	
	Compensation Ins. at \$	per C		\$	
	Trucking			\$	
	Pav't Patch			\$	
	<u>Top by Gifford & Co.</u>			\$	
	<u>8-12-65.</u>			\$	
	O'head			\$	
				\$	

St. Uccas
Pl. 34
Ave. No. 34

Name of Owner _____
TAX ID# 303.13-5-1
Reed

Labor and Mat'l. Report Aug. 12 1965

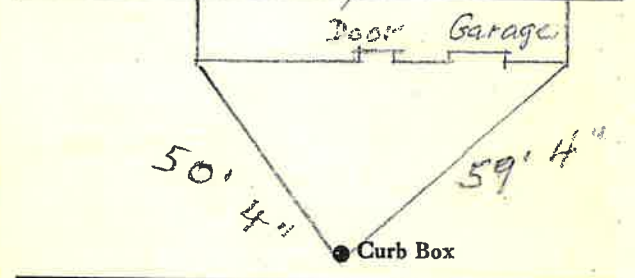

6" C.I. Main Elev. of Main at tap 4'

Gate at ● Gate at ●
24' to main

