

## Labor and Materials


/	Copper Lead	Connection	.....	\$	
/	Curb	Cock Valve T. S. & V.	Wheel Valve ..... in	\$	
/	Service Box Old returned	Short - 3 1/2 x 4 1/2 Long - 4 1/2 x 5 1/2 Buff. or Rdway	.....	\$	
/	Ft. / in.	Copper Galv Iron Cast Iron	Pipe at .....	\$	
	Nipples	..... in. at	.....	\$	
	Bushings	..... to .....	in. at .....	\$	
	Red'g Inc'g	Conplings .....	to .....	in. at .....	\$
	Union	..... in. at	.....	\$	
	Meter	..... in. at	.....	\$	
	Lead Joints	at .....	.....	\$	
	Leadite Joints	at .....	.....	\$	
	Hrs. Foreman	at .....	.....	\$	
	Hrs. Chauffeur	at .....	.....	\$	
	Hrs. Tapper	at .....	.....	\$	
	Hrs. Labor	at .....	.....	\$	
	Hrs. Labor	at .....	.....	\$	
	Hrs. Compressor	at .....	.....	\$	
	Compensation Ins.	.....	.....	\$	
	Trucking	.....	.....	\$	
	Builders Use of Water	.....	.....	\$	
				\$	
				\$	
				\$	
				\$	

St. 5-  
Pt.  
Ave. No. 34-36

Union

Name of Owner  
TAX ID # 302,20-12-12

Labor and Mat'l. Report 1923

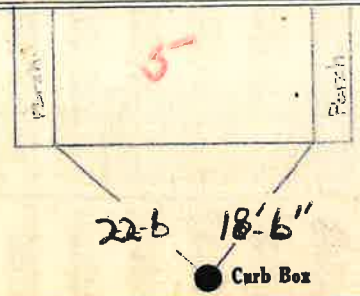

4" Main GALV.      Elev. of Main at tap... 5'

Gate at ●      ● Gate at

● Curb Box

WHEEL VALVE (BUFFALO)