

Labor and Materials

1	Copper	Connection	3	\$ 2.60
1	Lead		1	
1	Curb	Cock Valve P.S. & V.	1	\$ 2.27
1	Service Box	Short 3/4x4 1/2		\$ 1.59
	Old returned	Long 4 1/2x5 1/2		
		Buff or Redway		
9	Ft.	3 in. Copper Galv. Iron Pipe at		\$ 1.62
		Cast Iron		
	Nipples	in. at		\$
1	Bushings	1/2 to 3/4 in. at		\$ 1.0
	Red'g Inc'g	Couplings	to	in. at
	Union	in. at		\$
	Meter	in. at		\$
	Lbs. Br. Stone	at		\$
	Lbs. Sand	at		\$
	Bags Cement	at		\$
	Paving Brick	Mack Red Asphalt at		\$
	Lead Joints	at		\$
	Leadite Joints	at		\$
5	Hrs.	Foreman at		\$ 3.13
16	Hrs.	Common Labor at		\$ 7.20
	Hrs.	Common Labor at		\$
	Hrs.	Mason at		\$
	Hrs.	Mason's Helper at		\$
	Hrs.	Compressor at		\$
	Compensation Ins			\$ 3.2
	Trucking			\$ 1.00
	Builders' Use of Water	Patch		\$ 5.00
	Total			\$ 24.83


31-234

24

Labor and Material Report

Nov 17 1931

13 1/2 - 13 - 2

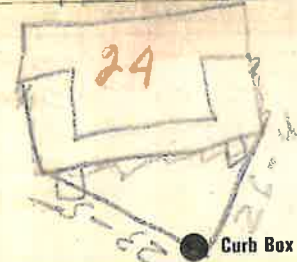

4 Main Elev of Main at tap 9' 40 MAIN Gate at

Curb Box

Gal Pipe 4"  
 old Tap shut off  
 This House Razed,  
 1965