

117-1851

UNION


St. ~~Pl.~~
Ave. No. 31-A

Name of Owner

Gallagher

Labor and Mat'l. Report

July 26 1951

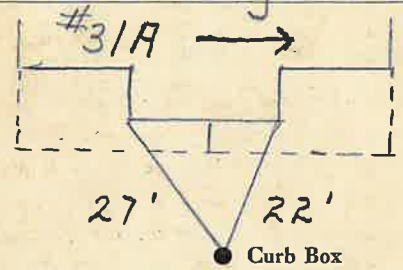

4" galv. Main

Elev. of Main at tap 6'

Gate at ●

● Gate at

● Curb Box

This tap for 31A ONLY

LSM-SC 10-21-49

UNION


St. ~~Pl.~~
Ave. No. 31

Name of Owner

LAUREN COON

Labor and Mat'l. Report

2003

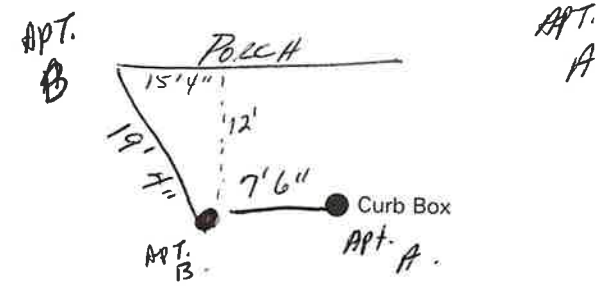

Main

Elev. of Main at tap

Gate at ●

● Gate at

3/4" Copper

20' to main

● Curb Box

Each APT. HAS OWN
SHUT OFF
LOCATED 7'6" APART

TAX ID # 302.20-13-5

LABOR AND MATERIALS

1	Copper	{ Connection	3/4"		\$ 3.20
	Lead				
1	Curb	{ Cock Valve	3/4 in.		\$ 1.00
		{ T.S. & V.			
1	Service box	{ Short 3 1/2 x 4 1/2			
	Old returned	{ Long 4 1/2 x 5 1/2			
		{ Buff or Rdway		\$ 1.40	
20	Ft. 3/4 in.	{ Copper			
		{ G.I.			
		{ G.I.		\$ 4.40	
	Nipples	in. at			\$
	Bushings	to in. at			\$
	Red'g	{ Coupl'gs	to in. at		\$
	Ine'g				
	Union	in. at			\$
	Meter	in. at			\$
	Lead Joints	at			\$
	Compound Joints	at			\$
? 4	Hrs. Water Maint. Man—1	at 62.5		\$ 2.50	
? 1	Hrs. Water Maint. Man—2	at		\$	
10	Hrs. Labor	at 50		\$ 5.00	
7	Hrs. Labor	at 40 5/8		\$ 2.84	
	Hrs. Compressor	at		\$	
	Compensation Ins. at \$	per C.		\$ 27	
1	Trucking			\$ 1.00	
	Pav't Patch			\$	
				\$	
				\$	
				\$	
	O'head			\$	
				\$ 21.61	

27-59? 31-B


UNION

St. Pl. Ave. No. 31-B

Name of Owner

This house was 4+6 UNION

Labor and Mat'l. Report May 25 19 27

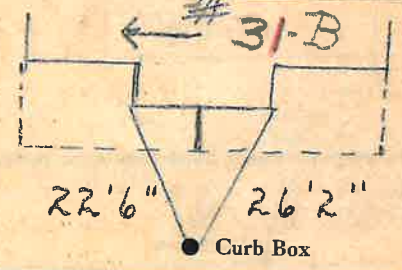

4" galv. Main

Elev. of Main at tap 6'

Gate at ●

● Gate at

● Curb Box

This tap for 31-B ONLY