


Labor and Materials

Lead	Copper } Connection.....	3/4	\$ 2.20
Curb	Cock Valve } in.....	2	\$ 1.00
	T. S. & V. }	4	
Service Box	Short 3/4 x 1 1/2 }		\$ 1.40
Old returned	Long 4 1/2 x 5 1/2 }		
	Butt or Rdway }		
Pt.....in.	Copper } Pipe at.....	7	\$ 1.76
	Galv. Iron }		
	Cast Iron }		
Nipples.....	in. at.....		\$
Bushings.....	to.....in. at.....		\$
Red'g } Couplings.....	to.....in. at.....		\$
Inc'g }			
Union.....	in. at.....		\$
Meter.....	in. at.....		\$
Lbs. Br. Stone at.....			\$
Lbs. Sand at.....			\$
Bags Cement at.....			\$
Paving Brick	Mack } at.....		\$
	Red }		
	Asphalt }		
Lead Joints at.....			\$
Leadite Joints at.....			\$
9 Hrs. Foreman at.....			\$ 1.88
13 Hrs. Common Labor at.....			\$ 5.28
Hrs. Common Labor at.....			\$
Hrs Mason at.....			\$
Hrs Mason's Helper at.....			\$
1 Hrs. Compressor at.....			\$ 1.50
Compensation Ins.....			\$ 19
Trucking.....			\$ 1.05
Builders' Use of Water.....			\$
Total \$			17.21

28-96 32 Aug 9 1929

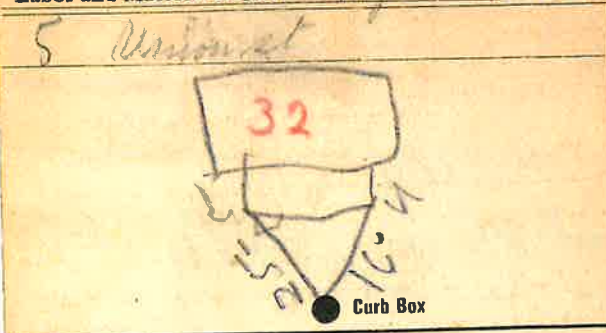

4 gal Main Elev of Main at tap 5

Gate at ● Gate at ●

8' to MAIN

● Curb Box

Old tap shut off

THIS HOUSE RAZED

1965