


Labor and Materials

Copper } Connection.....	3	\$ 1.48
Lead }	4	
Curb } Cock Valve }	3	\$ 1.79
} T.S.&V. }	4	
Service Box } Short 3 1/2 x 4 1/2 }		\$ 1.30
Old returned } Long 4 1/2 x 6 1/2 }		
} Bell or Rdway }		
26 Ft. } Copper } Pipe at		\$ 4.68
} Galv. Iron }		
} Cast Iron }		
Nipples	in. at	\$
Bushings	to 1/2 in. at 3/4	\$ 1.0
Red'g } Couplings.....to.....in.at.....		\$
Inc'g }		
Union.....in. at		\$
Meter.....in. at		\$
Lbs. Br. Stone at		\$
Lbs. Sand at		\$
Bags Cement at		\$
Paving Brick } Mack } at		\$
} Red }		
} Asphalt }		
Lead Joints at		\$
Leadite Joints at		\$
4 Hrs. Foreman at		\$ 2.50
8 Hrs. Common Labor at Tapper.....		\$ 4.00
8 Hrs. Common Labor at		\$ 3.60
Hrs. Mason at		\$
Hrs. Masons Helper at		\$
Hrs. Compressor at		\$
Compensation Ins		\$ 31
Trucking		\$ 1.00
Builders Use of Water with		\$ 5.00
Total \$		25.96

S 32-126 7
Labor and Material Report Oct 21 1937

3 Vanderhuden St

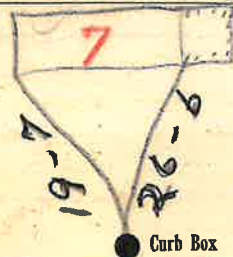

6" Main

Elev. of Main at tap 5

Gate at 3/4" COPPER 26' to MAIN Gate at

Curb Box

old Tap shut off at MAIN

TAX ID# 302.16-16-11

OK