


Labor and Materials

Copper } Connection.....	3	\$ 2.70
Lead } .....		
Curb } Cock Valve } .....	4 3/4	\$ 2.39
} S & V. } .....	1 1/2	
Service Box } Short 3/4x4 1/2 } .....		\$ 1.45
Old returned } Long 4x5 1/2 } .....		
} Buff or Railway } .....		
15 Ft. .... in. } Copper } Pipe at.....	3/4	\$ 4.05
} Galv. Iron } .....		
} Cast Iron } .....		
Nipples..... in. at.....		\$ .10
Bushings..... 1/2 to 3/4 in. at.....		\$ .10
Red'g } Couplings..... to..... in. at.....		\$
Inc'g } .....		\$
Union..... in. at.....		\$
Meter..... in. at.....		\$
Lbs. Br. Stone at.....		\$
Lbs. Sand at.....		\$
Bags Cement 'at.....		\$
Paving Brick } Mack } at.....		\$
} Red } .....		\$
} Asphalt } .....		\$
Lead Joints at.....		\$
Leadite Joints at.....		\$
2 Hrs. Foreman at.....		\$ 1.25
4 Hrs. Common Labor at Tapper @ 50		\$ 2.00
Hrs. Common Labor at.....		\$
Hrs. Mason at.....		\$
Hrs. Mason's Helper at.....		\$
Hrs. Compressor at.....		\$
Compensation Ins.....		\$ .10
Trucking.....		\$ 1.-
Builders' Use of Water.....	Patch	\$ 5.-
Total		\$ 70.00

30-159 26R  
 Labor and Material Report Nov 4 1930

12 1/2 Vanderhyden St.

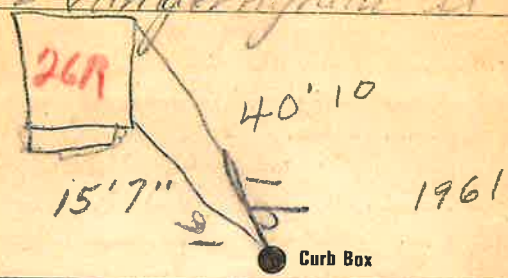

6 Main Eley of Main at tap 5  
 Gate at ● Gate at ●

● Curb Box

old Tap  
 shut off

TAX ID # 302.16-13-3