

### Labor and Materials

1	Copper	Connection	3/4		\$ 1.23
	Lead				
1	Curb	Cock Valve	3/4 in		\$ 1.68
		T.S. & V.			
1	Service Box	Short	3 1/2 x 4 1/2		\$ 1.75
	Old returned	Long	4 1/2 x 5 1/2		
		Buff. or Rdway			
9	Ft.	3/4 in.		Pipe at 15	\$ 1.35
	Nipples				\$
1	Bushings	3/4 to 1/2			\$ .04
	Red'g Inc'g	Conplings			\$
	Union				\$
	Meter				\$
	Lead Joints				\$
	Leadite Joints				\$
	Hrs. Foreman				\$
1 1/2	Hrs. Chauffeur		6 2/2		\$ .94
1 1/2	Hrs. Tapper				\$ .94
7 1/2	Hrs. Labor		4.5		\$ 3.37
	Hrs. Labor				\$
	Hrs. Compressor				\$
	Compensation Ins.				\$ .16
	Trucking				\$ 1.00
	Builders Use of Water	no patch (B.P.)			\$
	Tap by Kessel				\$
					\$
					\$
					\$ 1.246


34 - 1938

St. **30**  
Pl. **16**  
Ave. No. **16**

Name of Owner

Devol

Labor and Mat'l. Report *June 21* 19*38*

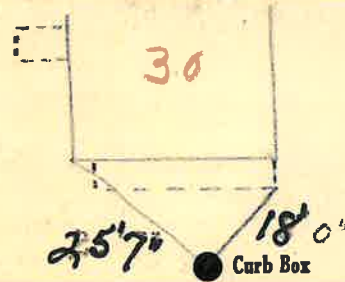

6 Main Elev. of Main at tap *9 1/2*

Gate at • 3/4" copper 9' to main • Gate at

● Curb Box

TAX ID # 302.16-13-5

*Paid* *old shot off*