

Labor and Materials


1	Copper Lead	Connection	3/4		\$ 1.23
1	Curb	Cock Valve-T.S. & V.	3/4	in.	\$ 1.68
1	Service Box Old returned	Short 3 1/2 x 4 1/2 Long 4 1/2 x 5 1/2 Buff. or Rdway			\$ 1.75
9	Ft. 3/4 in.	Copper Galv. Iron Cast Iron		Pipe at	\$ 1.35
	Nipples	in. at			\$
	Bushings	to in. at			\$
	Red'g Inc's	Conplings to in. at			\$
	Union	in. at			\$
	Meter	in. at			\$
	Lead Joints	at			\$
	Leadite Joints	at			\$
	Hrs. Foreman	at			\$
1 1/2	Hrs. Chauffeur	at			\$ 94
1 1/2	Hrs. Tapper	at			\$ 94
7 1/2	Hrs. Labor	at			\$ 3.38
	Hrs. Labor	at			\$
	Hrs. Compressor	at			\$
	Compensation Ins.				\$ 1.6
	Trucking				\$ 1.-
	Builders Use of Water	hospital (CPI)			\$
		copy by Hoessell			\$
					\$
					\$
					\$
					\$
					\$ 12.43

9 2 - 1938

St. 32  
Pl. Ave. No. 18

Name of Owner  
Stevens

Labor and Mat'l, Report June 21 1938

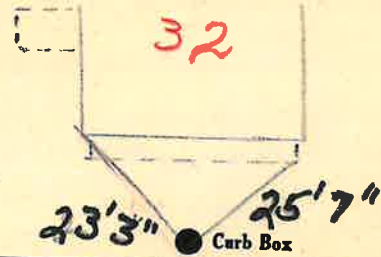

6 Main

Elev. of Main at tap 4 1/2

Gate at 3/4" copper Gate at 9' to main

Curb Box

TAX ID # 302.16-13-6

To be Billed old slip # etc etc