

Labor and Materials

1	Copper } Connection.....	3	\$ 2.70
1	Lead } Connection.....	3	\$ 2.70
1	Curb } Cock Valve } E. S. & V. } in.....	3	\$ 7.39
1	Service Box } Short 3/4x4 1/2 } Long 1 1/2x5 1/2 } Buff. or Rdway } Old returned }		\$ 1.45
28	Pt.....in.	3	\$ 7.56
	Nipples.....in. at.....		\$
1	Bushings... 1/2 to 3/4 in. at.....		\$.10
	Red'g } Couplings.....to.....in. at.....		\$
	Inc'g }		\$
	Union.....in. at.....		\$
	Meter.....in. at.....		\$
	Lbs. Br. Stone at.....		\$
	Lbs. Sand at.....		\$
	Bags Cement at.....		\$
	Paving Brick } Mack } Red } Asphalt } at.....		\$
	Lead Joints at.....		\$
	Leadite Joints at.....		\$
3	Hrs. Foreman at.....		\$ 1.88
16	Hrs. Common Labor at.....		\$ 7.20
	Hrs. Common Labor at.....		\$
	Hrs. Mason at.....		\$
	Hrs. Mason's Helper at.....		\$
	Hrs. Compressor at.....		\$
	Compensation Ins.....		\$ 28
	Trucking.....		\$ 1.00
	Builders' Use of Water.....	Patch	\$ 5.00
	Total \$		79.56


30-128

37

25 19 30

Labor and Material Report

21 Vandermuden St

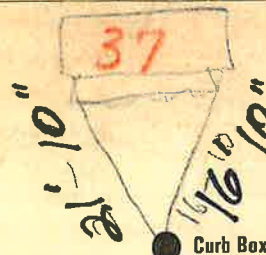

Main Elev of Main at tap 5

Gate at 3/4" Copper 28' to MAIN Gate at

Curb Box

old tap disconnected

TAX ID # 302.12-27-110