

Labor and Materials

1	Copper Lead	Connection	3/4		\$ 1.23	
1	Corb	Cock Valve T. S. & V.	3/4 in		\$ 1.68	
1	Service Box	} Short 3 1/2 x 4 1/2 Long 4 1/2 x 5 1/2 Buff. or Rdway			\$ 1.75	
	One returned					
9	Ft.	} Copper Cast Iron Cast Iron	3/4 in.	Pipe at	\$ 1.35	
	Nipples		in. at		\$	
	Bushings		to	in. at	\$	
	Red'g Inc'g	} Conplings		to	in. at	\$
	Union		in. at		\$	
	Meter		in. at		\$	
	Lead Joints		at		\$	
	Leadite Joints		at		\$	
	Hrs. Foreman		at		\$	
1 1/2	Hrs. Chauffeur		at	6 1/2	\$ 9.4	
1 1/2	Hrs. Tapper		at	7	\$ 9.4	
7 1/2	Hrs. Labor		at	45	\$ 3.38	
	Hrs. Labor		at		\$	
	Hrs. Compressor		at		\$	
	Compensation Ins.				\$ 1.6	
	Trucking				\$ 1.00	
	Builders Use of Water				\$	
					\$	
					\$	
					\$ 12.43	

8 6 - 1938


St. 12
Pl.
Ave. No. 6

Vanderlipden

Name of Owner

Hooly

Labor and Mat'l. Report June 16 1938

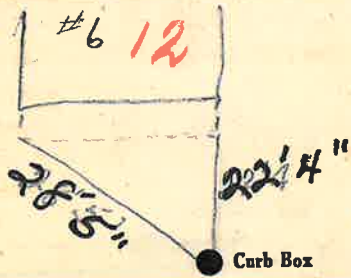

6 Main Elev. of Main at tap 7 1/2

Gate at ● ● Gate at

● Curb Box
9' to MAIN
TAX ID # 302.16-15-3

to be replaced add sheet of the