


LABOR AND MATERIALS

1 Copper } Connection $\frac{3}{4}$ " \$
 Lead }
 1 Curb } Cock } $\frac{3}{4}$ " Oriseel, \$
 Valve }
 T.S. & V. }
 1 Service box } Short $3\frac{1}{2} \times 4\frac{1}{2}$ \$
 Old returned } Long $4\frac{1}{2} \times 5\frac{1}{2}$ \$
 Buff or Rdway }
 24 Ft. $\frac{3}{4}$ in. } Copper } Pipe at \$
 } ~~S.I.~~ }
 } ~~C.I.~~ }
 Nipples in. at \$
 1 Bushings 1 to $\frac{3}{4}$ in. at \$
 Red'g }
 Inc'g } Coupl'gs to in. at \$
 Union in. at \$
 Meter in. at \$
 Lead Joints at \$
 Compound Joints at \$
 Maintenance Foreman \$
 Hrs. Water Maint. Man-1 at \$
 Hrs. Water Maint. Man-2 at \$
 Hrs. Garage Foreman at \$
 Hrs. Labor at \$
 Hrs. Compressor at \$
 Compensation Ins. at \$ per C \$
 Trucking \$
 Pav't Patch \$
 Tap by Larcant Donara \$
 10-27-65 \$
 O'head \$
 \$

Vanderheyden St. Pt. Ave. No. 21

Name of Owner LUNT

Labor and Mat'l. Report Oct. 27 1965

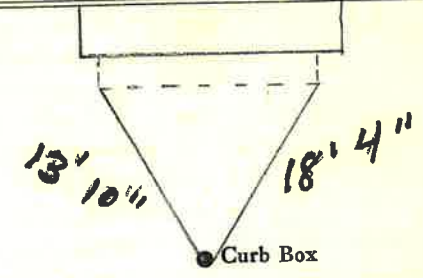

6" Main Elev. of Main at tap 4'

Gate at • Gate at
 $\frac{3}{4}$ " Copper 24' to main
 • Curb Box

TAX ID # 302.16-14-19