

Labor and Materials

1	Copper Lead	{ Connection $3/4$ in	\$ 1.23
1	Curb	{ Cock Valve } F.S. & V. } $3/4$ in	\$ 1.68
1	Service Box Old returned	{ Short $3\frac{1}{2} \times 4\frac{1}{2}$ Long $4\frac{1}{2} \times 5\frac{1}{2}$ Buff. or Rdway }	\$ 1.75
23	Ft. $3/4$ in.	{ Copper Galv Iron Cast Iron } Pipe at	\$ 3.45
	Nipples	in. at	\$
1	Bushings	$3/4$ to $1/2$ in. at	\$.03
	Red'g Inc'g }	Couplings to in. at	\$
	Union	in. at	\$
	Meter	in. at	\$
	Lead Joints at		\$
	Leadite Joints at		\$
	Hrs. Foreman at		\$
1 1/2	Hrs. Chauffeur at		\$ 94
1 1/2	Hrs. Tapper at		\$ 94
7 1/2	Hrs. Labor at		\$ 3.37
	Hrs. Labor at		\$
	Hrs. Compressor at		\$
	Compensation Ins.		\$.16
	Trucking		\$ 1.00
	Builders Use of Water	no patch (B. P.)	\$
	Tap by Wasserkel		\$
			\$
			\$
			\$
			\$ 14.55


9 0 - 1938

St. 23
Pl. 75
Ave. No.

Name of Owner

Vivian Hodgson

Labor and Mat'l. Report 6/20-38 19

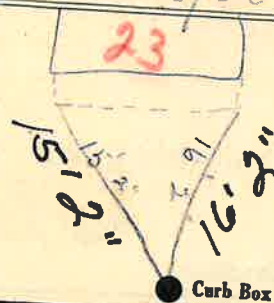

6 Main Elev. of Main at tap 4

Gate at $3/4$ " COPPER 23' to MAIN Gate at

Curb Box

to be Billed old shot city