

Labor and Materials

Copper } Connection	\$ 2.60
Lead } Connection	
Curb } Cock Valve } in.	\$ 2.30
T.S. & V. }	
Service Box } Short 3/4x1 1/2 }	\$ 1.40
Old returned } Long 1 1/2x2 1/2 }	
} Buff. or Rdway }	
Ft. in. } Copper Galv. Iron } Pipe at	\$ 1.86
} Cast Iron }	
Nipples in. at	\$
Bushings to in. at	\$
Red'g } Couplings to in. at	\$
Inc'g }	
Union in. at	\$
Meter in. at	\$
Lbs. Br. Stone at	\$
Lbs. Sand at	\$
Bags Cement at	\$
Paving Brick } Mack Red Asphalt } at	\$
Lead Joints at	\$
Leadite Joints at	\$
3 Hrs. Foreman at	\$ 1.88
1.2 Hrs. Common Labor at	\$ 4.88
Hrs. Common Labor at	\$
Hrs. Mason at	\$
Hrs. Mason's Helper at	\$
Hrs. Compressor at	\$.17
Compensation Ins.	\$
Trucking	\$ 1.00
Builders' Use of Water Patch	\$ 5.00
Total	\$ 21.10


29-168

24

Sept 15 1929

Labor and Material Report

10-10 1/2 Vandewater St

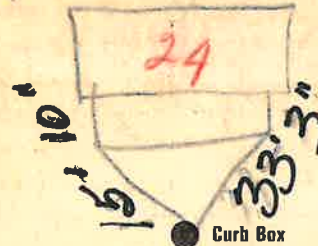

6 Main

Elev of Main at tap

Gate at

3/4" copper

Gate at

7' to MAIN

● Curb Box

TAX ID # 302.16-13-1