

LABOR AND MATERIALS


1	Copper	Connection	$\frac{3}{4}$	\$	_____
	Lead				
1	Curb	Cook Valve	$\frac{3}{4}$ in.	\$	_____
		T.S. & V.			
1	Service box	Short $3\frac{1}{2} \times 4\frac{1}{2}$		\$	_____
	Old returned	Long $4\frac{1}{2} \times 5\frac{1}{2}$			
		Buff or Rdway			
8'	Ft. $\frac{3}{4}$ in.	Copper		\$	_____
		G. I.			
		C. I.	Pipe at		
	Nipples	in. at		\$	_____
	Bushings	to in. at		\$	_____
	Red'g				
	Inc'g	Coupl'gs to in. at		\$	_____
	Union	in. at		\$	_____
	Meter	in. at		\$	_____
	Lead Joints at			\$	_____
	Compound Joints at			\$	_____
	Maintenance Foreman			\$	_____
	Hrs. Water Maint. Man-1 at			\$	_____
	Hrs. Water Maint. Man-2 at			\$	_____
	Hrs. Garage Foreman at			\$	_____
	Hrs. Labor at			\$	_____
	Hrs. Compressor at			\$	_____
	Compensation Ins. at \$	per C		\$	_____
	Trucking			\$	_____
	Pav't Patch			\$	_____
				\$	_____
				\$	_____
	Tap Sept 16, 1977			\$	_____
	St. John + Co.			\$	_____
	O'head			\$	_____
				\$	_____

Wait

St. Pt. Ave. No. 5

Name of Owner Dan Fragassi

Labor and Mat'l. Report Sept 16, 1977

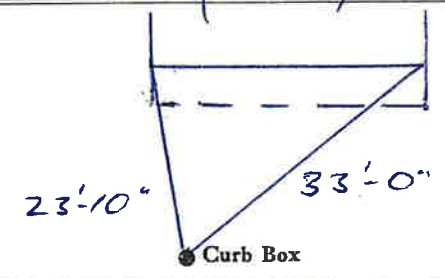

6" Main Elev. of Main at tap 5'

Gate at 3/4" Copper Gate at 8' to main

● Curb Box

TAX ID # 302.20-13-13