


**Labor and Materials**

.. Copper } Connection..... <sup>3</sup> / <sub>4</sub> .....	\$ 1.25
.. <del>Lead</del> } Cock Valve } .....in..... <sup>?</sup>	\$ 1.70
.. Service Box } Short 2 1/2 x 4 1/2 } Old returned } Long 4 1/2 x 5 1/2 } } Buff. or Rdway }	\$ 1.45
.. 1.9 Ft. 3/4 in. } Copper Galv. Iron } Pipe at .....	\$ 2.57
} Cast Iron }	
..... Nipples .....in. at .....	\$ .....
..... Bushings .....to .....in. at.....	\$ .....
..... Red'g } Couplings.....to.....in. at.....	\$ .....
..... Inc'g }	
..... Union.....in. at .....	\$ .....
..... Meter.....in. at .....	\$ .....
..... Lbs. Br. Stone at .....	\$ .....
..... Lbs. Sand at .....	\$ .....
..... Bags Cement at .....	\$ .....
..... Paving Brick } Mack Red Asphalt } at .....	\$ .....
..... Lead Joints at .....	\$ .....
..... Leadite Joints at .....	\$ .....
.. 4 Hrs. Foreman at ..... <sup>6.2</sup> / <sub>10</sub> .....	\$ 2.50
.. 4 Hrs. Common Labor at ..... <sup>50</sup> .....	\$ 2.00
.. 8 Hrs. Common Labor at ..... <sup>45</sup> .....	\$ 3.60
..... Hrs. Mason at .....	\$ .....
..... Hrs. Masons Helper at .....	\$ .....
..... Hrs. Compressor at .....	\$ .....
..... Compensation Ins .....	\$ 1.31
..... Trucking .....	\$ 1.00
..... Builders Use of Water Patch.....	\$ 5.00
Total \$ 21.38	

1935-31

Labor and Material Report *May 17* 19

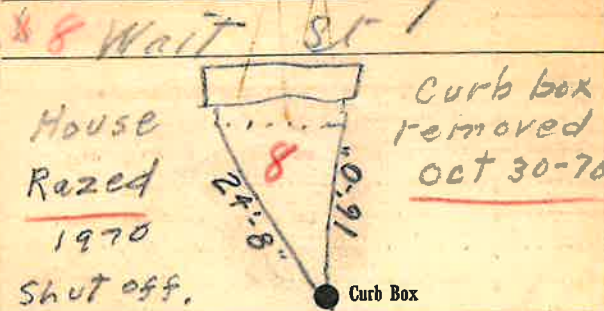

6 Main Elev. of Main at tap <sup>5 1/2</sup>

Gate at ● Gate at ●

