


33-46

Labor and Material Report

July 13 19

210 Wait St

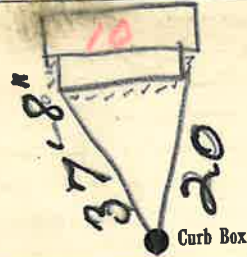

6 Main

Elev. of Main at tap 4 1/2

Gate at 3/4" copper 18' to main Gate at

● Curb Box

old Tap shut off at Main


m

St. Pl. Ave. No.

Name of Owner

10 WAIT ST

Labor and Mat'l. Report 19

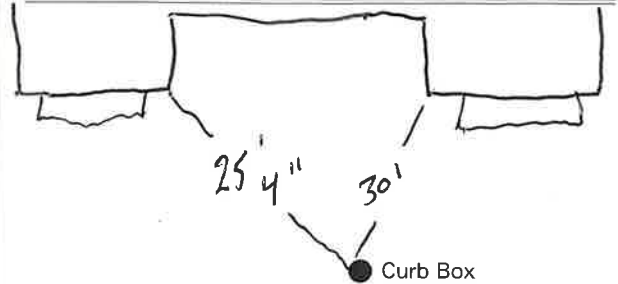

16' Main

Elev. of Main at tap

Gate at ●

● Gate at

● Curb Box

TAX ID # 302.20-17-4

### Labor and Materials

Copper } Connection.....	\$ 1.33
<del>Lead</del>	
Curb { Cock Valve T.S. & V. } .....in	\$ 1.58
Service Box { Short 3 1/2 x 4 1/2 Long 4 1/2 x 5 1/2 } Old returned { Built or Rewired }	\$ 1.36
18 Ft. ....in. { Copper Galv. Iron Cast Iron } Pipe at	\$ 1.71
Nipples .....in. at	\$
Bushings .....to .....in. at	\$
Red'g Inc'g } Couplings.....to.....in.at	\$
Union.....in. at	\$
Meter.....in. at	\$
Lbs. Br. Stone at	\$
Lbs. Sand at	\$
Bags Cement at	\$
Paving Brick { Mack Red Asphalt } at	\$
Lead Joints at	\$
Leadite Joints at	\$
8 Hrs. Foreman at	\$ 5-
Hrs. Common Labor at	\$
8 Hrs. Common Labor at	\$ 3.60
Hrs. Mason at	\$
Hrs. Masons Helper at	\$
Hrs. Compressor at	\$
Compensation Ins	\$ 26
Trucking	\$ 1-
Builders Use of Water <i>Patrol</i>	\$ 5-

Total \$ 20.94

### LABOR AND MATERIALS

Copper } Connection _____	\$ _____
Lead } _____	\$ _____
Curb { Cock Valve T.S. & V. } _____ in.	\$ _____
Service box { Short 3-1/2 x 4-1/2 } Old returned { Long 4-1/2 x 5-1/2 }	\$ _____
Ft. _____ in. { Copper G.I. C.I. } Pipe at	\$ _____
Nipples _____ in. at	\$ _____
Bushings _____ to _____ in. at	\$ _____
Red'g	
Inc'g	
Union _____ in. at	\$ _____
Meter _____ in. at	\$ _____
_____	\$ _____
Compound Joints at	\$ _____
Maintenance Foreman	\$ _____
Hrs. Water Maint. Man - 1 at	\$ _____
Hrs. Water Maint. Man - 2 at	\$ _____
Hrs. Garage Foreman _____ at	\$ _____
Hrs. Labor _____ at	\$ _____
Hrs. Compressor at	\$ _____
_____	\$ _____
Trucking	\$ _____
Pav't Patch	\$ _____
_____	\$ _____
_____	\$ _____
