

LABOR AND MATERIALS

1	Copper	Connection	3/4	\$ 2.87	
	Lead				
1	Curb	Cock Valve	3/4 in.	\$ 3.62	
		T. S. & V.			
1	Service box	Short 3 1/2 X 4 1/2			\$ 4.68
	Old returned	Long 4 1/2 X 5 1/2			
		Buff or Rdway			
10	Ft.	3/4 in. Copper	Pipe at 32	\$ 3.20	
		C.I.			
		C.I.			
	Nipples	in. at		\$	
	Bushings	to in. at		\$	
	Red'g				
	Inc'g	Coupl'gs to in. at		\$	
	Union	in. at		\$	
	Meter	in. at		\$	
	Lead Joints	at		\$	
	Compound Joints	at		\$	
3	Hrs. Water Maint. Man-1	at	1.12	\$ 3.36	
1	Hrs. Water Maint. Man-2	at	1.02	\$ 1.02	
14	Hrs. Labor	at	9.1	\$ 12.74	
	Hrs. Labor	at		\$	
	Hrs. Compressor	at		\$	
	Compensation Ins.	at \$ 2.18 per C.		\$ 3.7	
	Trucking			\$ 2.00	
	Pav't Patch			\$ 10.25	
	Tap by meter			\$	
				\$	
				\$	
	O'head			\$	
				\$ 44.11	


15

St. _____
Pl. _____
Ave. No. 11

Wait
Name of Owner _____

Pepper

Labor and Mat'l. Report Curi 19 1949

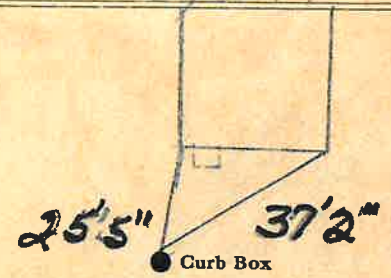

6 Main

Elev. of Main at tap 4 1/2

Gate at ● Gate at ●

3/4" copper 10' to main

● Curb Box

TAX ID # 302.20-13-10