

Labor and Materials


.. Copper	} Connection.....	3	\$. 1.33	
.. Lead		4		
.. Curb	} Cock Valve T.C. & V. } in	\$. 1.58	
.. Service Box				} Short 3 1/2 x 4 1/2 Long 4 1/2 x 5 1/2 Buff. or Edgew. }
.. Old returned				
.. 18 Ft.	} Copper Galv. Iron Cast Iron }	in. Pipe at	\$. 1.71	
.. Nipples			 in. at
.. Bushings to	in. at	\$	
.. Red'g .. Inc'g	} Couplings.....	to	in. at	\$
.. Union.....				
.. Meter.....	in. at	\$		
.. Lbs. Br. Stone	at	\$		
.. Lbs. Sand	at	\$		
.. Bags Cement	at	\$		
.. Paving Brick	} Mack Red Asphalt }	at	\$	
.. Lead Joints				at
.. Leadite Joints	at	\$		
.. 5 Hrs. Foreman	at	3.13		
.. Hrs. Common Labor	at	\$		
.. 7 Hrs. Common Labor	at	3.15		
.. Hrs. Mason	at	\$		
.. Hrs. Masons Helper	at	\$		
.. Hrs. Compressor	at	\$		
.. Compensation Ins		\$. 20		
.. Trucking		\$. 1.00		
.. Builders Use of Water	Patch	\$. 5.00		

Total \$ 18.46

33-47 12

Labor and Material Report July 13 1933

10 12 Wait

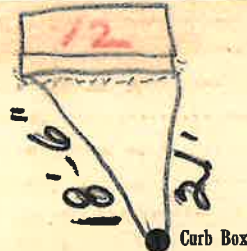

STOP IS ON WHEN IN OFF POSITION

6 Main

Elev. of Main at tap 4 1/2

Gate at 3/4" Copper

18' to Gate at MAIN

● Curb Box

old Tap shut off at Main

THH

711