


1" copper 26' to MAIN

Gate at ● Gate at ●  
Main at tap 9 Elev. of Main 7

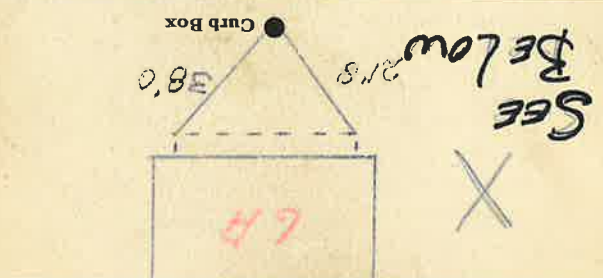

Labor and Mat'l. Report Dec 3 1940


Name of Owner Foley

St. Walnut Pt. Ave. No. 246-8

St. 6A Walnut Pt. Ave. No. 246-8

Name of Owner Foley


Labor and Mat'l. Report Dec 3 1940

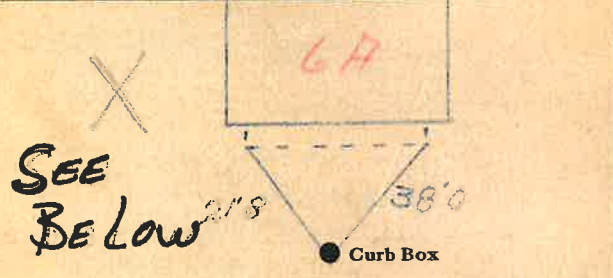

Main 7 Elev. of Main at tap 9

Gate at ● Gate at ●

1" copper 26' to MAIN

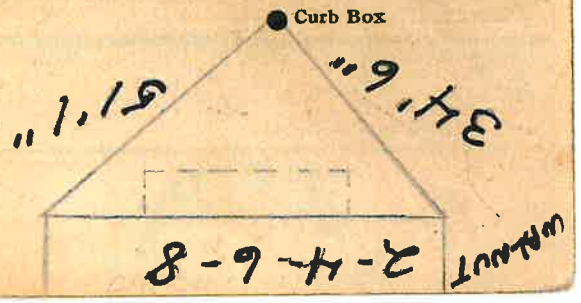

### LABOR AND MATERIALS

1/ Lead } Connection 7/11		\$ 2.14
1/ Curb { Cock Valve } 7/11 in.		\$ 3.61
1/ Service Box Old returned { Short 3 1/2 x 4 1/2 } { Long 4 1/2 x 5 1/2 }		\$ 1.60
26 Ft. 1" in. { Copper Galv Iron Cast Iron } Pipe at .22		\$ 5.72
..... Nipples..... in. at		\$
..... Bushings..... to..... in. at		\$
1 Red'g } Couplings 1' to 3/4 in. at		\$
1 Inc'g }		\$
..... Union..... in. at		\$
..... Meter..... in. at		\$
..... Lead Joints at		\$
..... Leadite Joints at		\$
..... Hrs. Foreman at		\$
10 Hrs. Chauffeur at .62 1/2		\$ 6.25
15 Hrs. Tapper at 7		\$ 9.38
25 Hrs. Labor at .45		\$ 11.25
..... Hrs. Labor at		\$
3 Hrs. Compressor at .62 1/2		\$ 1.87
..... Compensation Ins.		\$ .87
..... Trucking		\$ 1-
..... Builders Use of Water Patch		\$ 5-
<i>Tap by Hessel</i>		
.....		\$
.....		\$
.....		\$
.....		\$
		\$ 47.64