


Labor and Materials

| | | | | | |
|----|------------------------|--|-------------------|-------|---------|
| 1 | Copper | Connection | $\frac{3}{2}$ | \$ | 5.20 |
| 1 | Curb | Cock Valve T. S. & V. | in. $\frac{3}{4}$ | \$ | 1.00 |
| | Service Box | Short $3\frac{1}{2} \times 4\frac{1}{2}$ | | \$ | 1.30 |
| | Old returned | Long $4\frac{1}{2} \times 5\frac{1}{2}$ | | \$ | |
| | | Buff. or Rdway | | \$ | |
| 29 | Ft. | Copper Galv. Iron Pipe at | $\frac{3}{4}$ | \$ | 6.38 |
| | Nipples | in. at | | \$ | |
| | Bushings | to in. at | | \$ | |
| | Red'g Inc'g | Couplings to in. at | | \$ | |
| | Union | in. at | | \$ | |
| | Meter | in. at | | \$ | |
| | Lbs. Br. Stone | at | | \$ | |
| | Lbs. Sand | at | | \$ | |
| | Bags Cement | at | | \$ | |
| | Paving Brick | Mack Red Asphalt at | | \$ | |
| | Lead Joints | at | | \$ | |
| | Leadite Joints | at | | \$ | |
| 4 | Hrs. Foreman | at | $6\frac{1}{2}$ | \$ | 2.10 |
| 22 | Hrs. Common Labor | at | $40\frac{5}{8}$ | \$ | 8.94 |
| | Hrs. Common Labor | at | | \$ | |
| | Hrs. Mason | at | | \$ | |
| | Hrs. Mason's Helper | at | | \$ | |
| | Hrs. Compressor | at | | \$ | |
| | Compensation Ins. | | | \$ | .30 |
| | Trucking | | | \$ | 1.00 |
| | Builders' Use of Water | | | \$ | |
| | | | | Total | \$21.62 |

28-58

Labor and Material Report *June 13 1928*

20 Walnut St

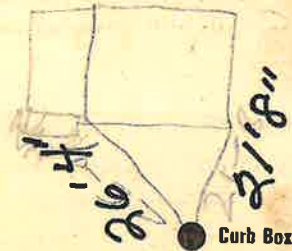

4 Main

Elev. of Main at tap *4 1/2*

Gate at ●

3/4" Copper 29' to MAN

● Gate at

● Curb Box

*old Tap to Be
Dug up*

TAX ID# 303.17-11-6