

NEW H₂O MAIN IN STREET

LABOR AND MATERIALS

✓	Copper	Lead	Connection	3/4		\$ 2.94
✓	Curb	Cock Valve	T. S. & V.	3/4 in.		\$ 3.71
✓	Service box	Short 3 1/2 X 4 1/2	Long 4 1/2 X 5 1/2		same	\$ —
✓	Old returned	Buff or Rdway			13 ft	\$ —
✓	4' Ft. 3/4 in.	Copper	G. I.	Pipe at	30	\$ 2.40
			C. I.			
	Nipples		in. at			\$
	Bushings		to in. at			\$
	Red'g					\$
	Inc'g	Coupl'gs	to in. at			\$
	Union		in. at			\$
	Meter		in. at			\$
	Lead Joints		at			\$
	Compound Joints		at			\$
3	Hrs. Water Maint. Man—1		at	91		\$ 3.03
3	Hrs. Water Maint. Man—2		at	91		\$ 2.73
11	Hrs. Labor—		at	80		\$ 8.80
	Hrs. Labor—		at			\$
	Hrs. Compressor		at			\$
	Compensation Ins.		at \$		per C	\$
	Trucking					\$ 1.00
	Pav't Patch					\$
	Tap by Miller					\$
	O'head					\$


COPPER SHORTENED \$24.93
 7-21-2003
 KH

111

St. _____
 Pl. _____
 Ave. No. 21211

Name of Owner
 G. J. Orsini

Labor and Mat'l. Report June 8 1948

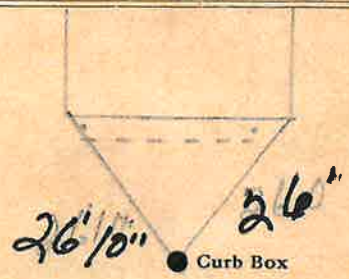

4 Main Elev. of Main at tap 4
 Gate at ● Gate at ●

3/4" Copper 4' to MAIN

● Curb Box

TAX ID # 303.17-12-12

LSM 5C 5 15-48

to be Billed ✓