

LABOR AND MATERIALS

✓	Copper	Connection	3/4	\$	1.35
	Lead				
✓	Curb	Cock Valve T.S. & V.	3/4 in.	\$	1.80
✓	Service Box	Short 3 1/2 x 4 1/2		\$	1.70
	Old returned	Long 4 1/2 x 5 1/2			
		Buffer Rdway			
4	Ft.	Copper Galv Iron Cast Iron	3/4 in. Pipe at 18	\$	1.26
	Nipples	in. at		\$	
	Bushings	to in. at		\$	
	Red'g Inc'g	Couplings to in. at		\$	
	Union	in. at		\$	
	Meter	in. at		\$	
	Lead Joints	at		\$	
	Leadite Joints	at		\$	
	Hrs. Foreman	at		\$	
4	Hrs. Chauffeur	at	6.21x	\$	2.50
4	Hrs. Tapper	at	4	\$	2.50
8	Hrs. Labor	at	45	\$	3.60
	Hrs. Labor	at		\$	
	Hrs. Compressor	at		\$	
	Compensation Ins.			\$.26
	Trucking			\$	1.00
	Builders Use of Water	Patch		\$	5.00
	Taps by P...			\$	
				\$	
				\$	
				\$	
				\$	0.97


COPPER SHORTENED
7-21-2003
KAT

3 3 1941

St. Walnut
Pl. Ave. No. 23

Name of Owner TAX ID # 303.17-12-11
Giovanni

Labor and Mat'l. Report 11-18 19-21

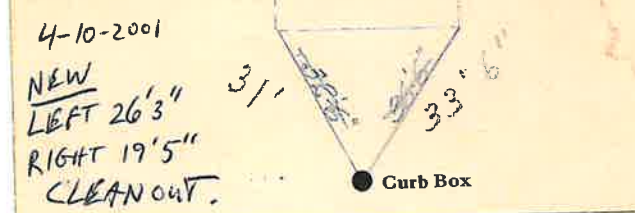

4 Main Elev. of Main at tap 4 1/2
Gate at Gate at
3/4" copper 4 to main

4-10-2001 PER BOB LINCH
LEFT 26'3"
RIGHT 19'5"
SEWER CLEAN OUT.