

LABOR AND MATERIALS


1	Copper	Connection	3/4		\$ 1.31
1	Curb	Cock Valve	3/4	in.	\$ 1.75
		T. S. & V.			
1	Service Box	Short 3/2x4 1/2 Long 4 1/2x5 1/2 Buff. or Rdway			\$ 1.60
	Old returned				
9	Ft.	3/4 in.		Pipe at 18	\$ 1.62
				{ Copper Galv Iron. Cast Iron }	
	Nipples	in. at			\$
	Bushings	to		in. at	\$
	Red'g Inc'g	Couplings	to	in. at	\$
	Union	in. at			\$
	Meter	in. at			\$
	Lead Joints	at			\$
	Leadite Joints	at			\$
	Hrs. Foreman	at			\$
3	Hrs. Chauffeur	at	6 1/2 hr		\$ 1.88
	Hrs. Tapper	at			\$
12	Hrs. Labor	at	45		\$ 5.40
	Hrs. Labor	at			\$
	Hrs. Compressor	at			\$
	Compensation Ins.				\$.23
	Trucking				\$ 1.-
	Builders Use of Water	Patch			\$ 5.-
	Taply Penner				\$
					\$
					\$
					\$ 19.79

245-1940

St.
Pl.
Ave. No. 27

Name of Owner
Walnut
Daley Est

Labor and Mat'l. Report Oct 29 1940

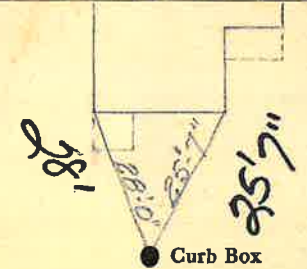

4 Main Elev. of Main at tap 4 1/2

Gate at ● ● Gate at

3/4" copper 9' to main

● Curb Box

TAX ID# 303.17-12-9