

LABOR AND MATERIALS

Copper	Lead	Connection	3/4	\$ 2.94	
	Curb	Cock Valve T. S. & V.	3/4 in.	\$ 3.71	
Service box	Old returned	Short 3 1/2 X 4 1/2	Long 4 1/2 X 5 1/2	Buff or Rdway	Sons \$
26 Ft. 3/4 in.		Copper	G. I.	Pipe at	30 \$ 7.80
Nipples					
Bushings					
Red'g					
Inc'g		Coupl'gs			
Union					
Meter					
Lead Joints					
Compound Joints					
3 Hrs. Water Maint. Man-1			at 1.01		\$ 3.03
4 Hrs. Water Maint. Man-2			at .91		\$ 3.64
1.1 Hrs. Labor			at .80		\$ 880
Hrs. Labor					
Hrs. Compressor					
Compensation Ins.			at \$		per C. \$ 34
Trucking					\$ 1.00
Pav't Patch		Before Paving			\$
Tap					\$
O'head					\$
					\$ 31.26

113


St. _____
Pl. _____
Ave. No. 28

Name of Owner

Mrs. Florence Ricciardelli

Labor and Mat'l. Report

June 9 1948

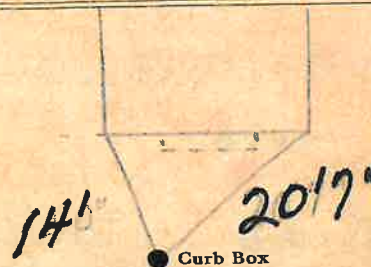

Main _____ Elev. of Main at tap _____

Gate at ● Gate at ●

3/4" Copper 26' to main

● Curb Box

TAX ID# 303.17-11-10

LSM-5C 5 15-48 *To be billed*