

**Labor and Materials**


1	Copper	Connection	3/4"	\$	3.20
	Lead				
1	Curb	Cock Valve	8 1/4" in.	\$	1.00
		F. S. & V.			
1	Service Box	Short	3 1/2 x 4 1/2	\$	1.20
	Old returned	Long	4 1/2 x 5 1/2		
		Buff. or Rdway			
10	Ft.	Copper		\$	2.20
		Galv. Iron	Pipe at		
		Cast Iron			
	Nipples		in. at	\$	
	Bushings		to in. at	\$	
1	Redd Ingr	Couplings	3/4" to Brass	\$	1.5
	Union		in. at	\$	
	Meter		in. at	\$	
	Lbs. Br. Stone	at		\$	
	Lbs. Sand	at		\$	
	Bags Cement	at		\$	
	Paving Brick	Mack Red Asphalt	at	\$	
	Lead Joints	at		\$	
	Leadite Joints	at		\$	
2	Hrs. Foreman	at	6 1/2	\$	1.25
	Hrs. Common Labor	at		\$	
6	Hrs. Common Labor	at	4 1/8	\$	2.42
	Hrs. Mason	at		\$	
	Hrs. Mason's Helper	at		\$	
	Hrs. Compressor	at		\$	
	Compensation Ins.			\$	11
	Trucking			\$	100
	Builders' Use of Water			\$	

Total \$ 127.5

**Labor and Material Report**

19 20

3/4" top of 9' at school

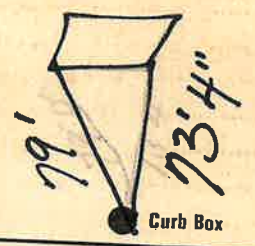

4" Main Elev. of Main at tap 4 1/2

Gate at 3/4" copper 10' to MAIN Gate at

● Curb Box