


Labor and Materials

Copper } Connection.....	$\frac{3}{4}$	\$ 320
Lead }	$\frac{1}{4}$	
Curb } Cock }	$\frac{3}{4}$	\$ 100
Valve }		
F.S. & C. }		
Service Box } Short 3 x 4 }		\$ 130
Old returned }		
9 Ft. } in. } Copper } Pipe at.....	$\frac{3}{4}$	\$ 198
Cast-iron }		
Nipples.....	in. at.....	\$
Bushings.....	$\frac{3}{4}$ to $\frac{3}{4}$ in. at.....	\$ 12
Red'g } Couplings.....	to..... in. at.....	\$
Inc'g }		
Union.....	in. at.....	\$
Meter.....	in. at.....	\$
Lbs. Br. Stone at.....		\$
Lbs. Sand at.....		\$
Bags Cement at.....		\$
Paving Brick } Mack } at.....		\$
Red }		
Asphalt }		
Lead Joints at.....		\$
Leadite Joints at.....		\$
Hrs. Foreman at.....		\$
8 Hrs. Common Labor at.....	62 1/2	\$ 188
5 Hrs. Common Labor at.....	170	\$ 250
5 Hrs. Mason at.....	40 1/8	\$ 203
Hrs. Mason's Helper at.....		\$
Hrs. Compressor at.....		\$
Compensation Ins.....		\$ 17
Trucking.....		\$ 100
Builders' Use of Water.....		\$
Total		\$ 1518

27-163
 Labor and Material Report Sept 16 1927

29 Walnut St

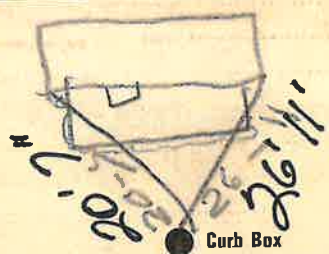

4 Main Elev. of Main at tap 5

Gate at 3/4" copper 9' to main Gate at

● Curb Box

Old silent off

TAX ID# 303.17-12-8