

LABOR AND MATERIALS


Copper	Connection	3/4		\$ 2.94
Lead	Cock	3/4	in.	\$ 3.71
Curb	Waive			
	T. S. & V.			
Service box	Short 3/2 X 4 1/2			\$ 5.90
Old returned	Long 4 1/2 X 5 1/2			
	Buff or Rdway			
23 Ft.	3/4 in.	Copper	Pipe at 30	\$ 6.90
		G.I.		
		C.I.		
Nipples	in. at			\$
Bushings	to in. at			\$
Red'g				\$
Inc'g	Coupl'gs to in. at			\$
Union	in. at			\$
Meter	in. at			\$
Lead Joints at				\$
Compound Joints at				\$
Hrs. Water Maint. Man-1 at				\$
8	Hrs. Water Maint. Man-2 at	1.02		\$ 81.69
13	Hrs. Labor- at	91		\$ 11.93
	Hrs. Labor- at			\$
	Hrs. Compressor at			\$
	Compensation Ins. at \$		per C	\$ 1.44
	Trucking			\$ 1.00
	Pav't Patch			\$
				\$
				\$
				\$
	O'head			\$
				\$ 40.86

133

St. _____
 Pl. _____
 Ave. No. 34

Walnut
 Name of Owner
 Del Signore

Labor and Mat'l. Report Sept 23 19 48

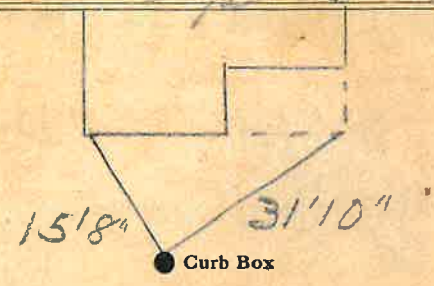

4 Main Elev. of Main at tap 5

Gate at ● Gate at ●

3/4" Copper 23' to main

● Curb Box

TAX ID# 303.17-2-1

SM-5C B 15-48

to be billed