

**Labor and Materials**



Copper Lead	Connection	3/4	\$ 2.70
Curb	Cock Valve T.S. & V.	3/4	\$ 2.39
Service Box Old returned	Short 3/4 x 1/2 Long 1 1/2 x 5/8 Buff or Rdway	3/4	\$ 1.45
22 Ft.	Copper Galv. Iron Pipe at	3/4	\$ 5.94
Nipples	in. at		\$
Bushings	to in. at		\$
Red'g Inc'g	Couplings to in. at		\$
Union	in. at		\$
Meter	in. at		\$
Lbs. Br. Stone	at		\$
Lbs. Sand	at		\$
Bags Cement	at		\$
Paving Brick	Mack Red Asphalt at		\$
Lead Joints	at		\$
Leadite Joints	at		\$
4 Hrs.	Foreman at 6 1/2		\$ 2.50
22 Hrs.	Common Labor at 45		\$ 9.90
Hrs.	Common Labor at		\$
Hrs.	Mason at		\$
Hrs.	Mason's Helper at		\$
Hrs.	Compressor at		\$
Compensation	Ins		\$ .38
Trucking			\$ 1. -
Builders' Use of Water	Patch		\$ 5. -
Total			\$ 31.26

30-51

**Labor and Material Report**

May 23 1930

40 Walnut St

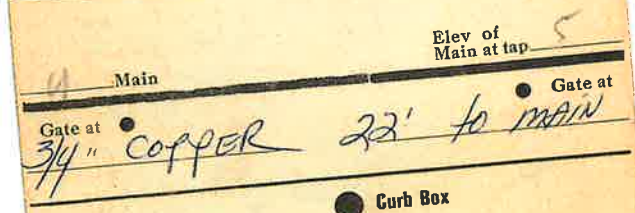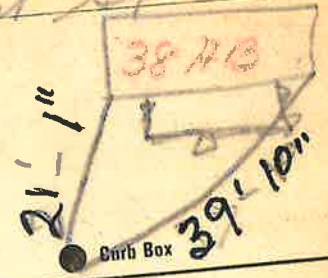

old tap to be dug up

TAX ID# 303.17-2-3