

LABOR AND MATERIALS

1	Copper Connection	3/4	\$	2.94
	Lead			
1	Curb Valve	3/4 in.	\$	3.71
	T. S. & V.			
	Service box	Short 3 1/2 X 4 1/2		
	Old returned	Long 4 1/2 X 5 1/2		
		Buffer Rdway		5.90
4' 10"				
10	Ft. 3/4 in.	Copper Pipe at 30	\$	3.00
		G. I.		
		G. I.		
	Nipples	in. at	\$	
	Bushings	to in. at	\$	
	Red'g			
	Inc'g	Coupl'gs to in. at	\$	
	Union	in. at	\$	
	Meter	in. at	\$	
	Lead Joints at		\$	
	Compound Joints at		\$	
	Hrs. Water Maint. Man-1 at		\$	
7	Hrs. Water Maint. Man-2 at	1.02	\$	1.14
13	Hrs. Labor-	91	\$	1.83
	Hrs. Labor-		\$	
	Hrs. Compressor at		\$	
	Compensation Ins. at \$	per C	\$	42
	Trucking		\$	1.02
	Pav't Patch	Before Paving	\$	
		Topsy McGinnis	\$	
			\$	
			\$	
	O'head		\$	
			\$	35.94

134


St. Walnut
 Pt. Ave. No. 41

Name of Owner

McGillivuddy

Labor and Mat'l. Report

Sept 23 19 41

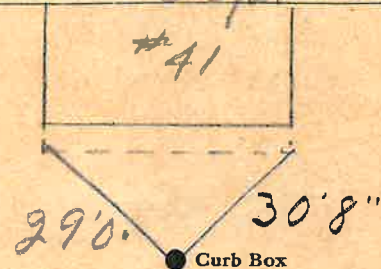

7 Main Elev. of Main at tap 5

Gate at ● Gate at ●
 3/4" Copper 4' 10" to main

● Curb Box
 TAX ID # 303.17-3-7

LSM-5C 9 15-48 To be Billed