

LABOR AND MATERIALS

1	Copper Lead	} Connection	3/4		\$ 1.35
1	Curb	{ Cock Valve T. S. & V.	3/4 in.		\$ 1.80
1	Service Box Old returned	{ Short 3 1/2 x 4 1/2			\$ 1.87
4 2"	10-17-03	{ Long 4 1/2 x 5 1/2			
	K14	{ Buffer Rdway			
8	Ft. 3/4 in.	{ Copper Galv Iron Cast Iron		Pipe at 191	\$ 1.72
	Nipples	in. at			\$
	Bushings	to in. at			\$
	Red'g Inc'g	{ Couplings to in. at			\$
	Union	in. at			\$
	Meter	in. at			\$
	Lead Joints	at			\$
	Leadite Joints	at			\$
	Hrs. Foreman	at			\$
6	Hrs. Chauffeur	at	6.874		\$ 4.12 ¹⁴
8	Hrs. Tapper	at			\$ 5.50 ⁰⁰
7	Hrs. Labor	at	1.60		\$ 4.20 ¹⁰
	Hrs. Labor	at			\$
1	Hrs. Compressor	at	8.717		\$.88
	Compensation Ins.		2.213		\$.31
	Trucking				\$ 1.07
	Builders Use of Water				\$ 5.95
	Tap by Miller				\$
					\$
					\$
					\$
					\$
					\$ 29.55


14-13

Walnut

St. 43
 Pt. 45
 Ave. No. 45

Name of Owner
Napolitano

Labor and Mat'l. Report June 14 1943

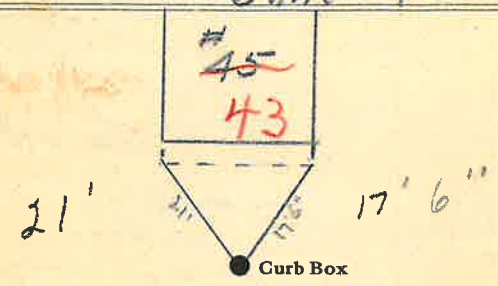

4 Main Elev. of Main at tap 5

Gate at ● ● Gate at
3/4" Copper 4'2" to main

● Curb Box

TAX ID# 303.17-3-6