

LABOR AND MATERIALS

/	Copper Lead	Connection	3/4	\$ 2.94	
/	Curb	Cock Valve T. S. & V.	3/4 in.	\$ 3.71	
26	Service box	Short 3 1/2 X 4 1/2			
10-17-2005	Old returned	Long 4 1/2 X 5 1/2		\$ 5.90	
23	Ft.	Buff or Rdway	30	\$ 6.90	
		Copper G. I. C. I.			
	Nipples	in. at		\$	
	Bushings	to in. at		\$	
	Red'g			\$	
	Inc'g	Coupl'gs to in. at		\$	
	Union	in. at		\$	
	Meter	in. at		\$	
	Lead Joints	at		\$	
	Compound Joints	at		\$	
	Hrs. Water Maint. Man-1	at		\$	
5	Hrs. Water Maint. Man-2	at	1.07	\$ 5.10	21/48
18	Hrs. Labor	at	91	\$ 16.38	21/48
	Hrs. Labor	at		\$	
	Hrs. Compressor	at		\$	
	Compensation Ins.	at \$ per C		\$ 47	
	Trucking			\$ 1.00	
	Pav't Patch	Before Paving		\$	
				\$	
	O'head			\$	
				\$ 42.40	

135

St.
Pl.
Ave. No. 44


Walnut

Name of Owner

Peter Villa

Labor and Mat'l. Report

Sept 27 1944

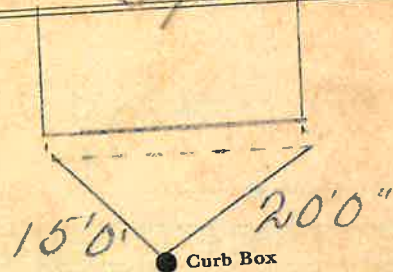

7 Main

Elev. of Main at tap

4

Gate at ●

● Gate at

3/4" Copper

26' to main

● Curb Box

TAX ID # 303.17-2-5