


### Labor and Materials

1	Copper Lead } Connection $3/4"$	\$320
1	Curb } Cock Valve T.S. & V. } $3/4"$ in.	\$150
1	Service Box } Short $3\frac{1}{2} \times 4\frac{1}{2}$ } Old returned } Long $4\frac{1}{2} \times 5\frac{1}{2}$ } Buff. or Rdway }	\$130
9	Ft. $3/4"$ in. } Copper Galv. Iron } Pipe at Cast Iron }	\$198
	Nipples.....in. at.....	\$
	Bushings.....to.....in. at.....	\$
	Red'g } Couplings.....to.....in. at..... Inc'g }	\$
	Union.....in. at.....	\$
	Meter.....in. at.....	\$
	Lbs. Br. Stone at.....	\$
	Lbs. Sand at.....	\$
	Bags Cement at.....	\$
	Paving Brick } Mack Red Asphalt } at.....	\$
	Lead Joints at.....	\$
	Leadite Joints at.....	\$
1	Hrs. Foreman at.....	\$1.63
6	Hrs. Common Labor at..... <i>vo</i>	\$3.00
	Hrs. Common Labor at.....	\$
	Hrs. Mason at.....	\$
	Hrs. Mason's Helper at.....	\$
	Hrs. Compressor at.....	\$
	Compensation Ins.....	\$1.10
	Trucking.....	\$1.00
	Builders' Use of Water.....	\$
	Total	\$17.21

27-129 Labor and Material Report Aug 4 1927


3/4 tap at 47-449 Walnut st

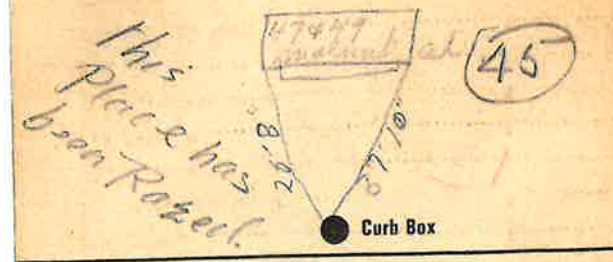

4 Main Elev. of Main at tap 4 ft

Gate at Gate at  
No of this place is old 45

Curb Box 9' to main

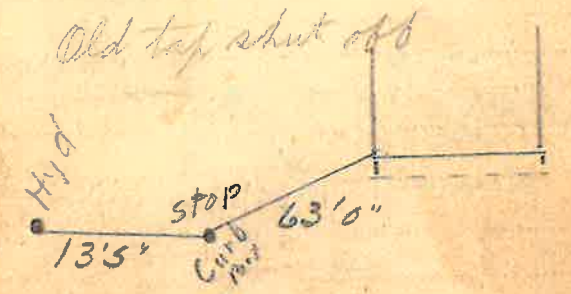

This place has been razed +  
Curb Box taken out  
Not shown  
effort