

139

Walnut


St. ~~Pl.~~
Ave. No. 54

Name of Owner

Pete Fiore

Labor and Mat'l. Report

Sept 21 19 48

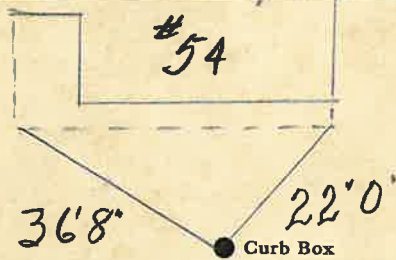

9 Main

Elev. of Main at tap 5

Gate at ●

● Gate at

3/4" Copper 24' to main

● Curb Box

LSM-5C 5 15-48

To be Billed

WALNUT


St. ~~Pl.~~
Ave. No. 54

Name of Owner

TAX ID # 303.17-2-10

Labor and Mat'l. Report

19 48

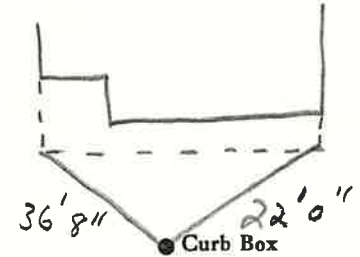

4" Main

Elev. of Main at tap 5'

Gate at ●

● Gate at

3/4" Copper 28'6" to main

● Curb Box

LSM-5C-6-1-67

