


LABOR AND MATERIALS

1	Copper Lead	Connection	1 1/4"	\$	8.18
1	Curb	Cock Valve	1 1/4 in.	\$	7.44
		P. S. & V.			
1	Service box	Short 3 1/2 X 4 1/2			
4 1/2	Old returned	Long 4 1/2 X 5 1/2			15.85
		Buff or Rdway			
1	Ft. 1 1/4 in.	Copper	Pipe at	6.2	6.20
1"	BEFORE C/B	G.I.			
		G.I.	1 1/4" TO BLDG		
	Nipples	in. at			
	Bushings	to in. at			
	Red'g				
	Inc'g	Coupl'gs to in. at			
	Union	in. at			
	Meter	in. at			
	Lead Joints	at			
	Compound Joints	at			
	Hrs. Water Maint. Man-1	at			
9	Hrs. Water Maint. Man-2	at	1.24		11.16
22	Hrs. Labor	at	1.13		24.86
	Hrs. Labor	at			
	Hrs. Compressor	at			
	Compensation Ins.	at \$4.406 per C			1.59
	Trucking				1.00
	Pay't Patch				18.11
	Tap by Gifford	12-19-52			
	O'head				
	1" REDUCER TO 1 1/4"				9.439

76.25

St. Walnut
 Pt. Ave. No. 61

Name of Owner
 Cronin and Mangine
 Laundry
 Labor and Mat'l. Report Dec 19 1952

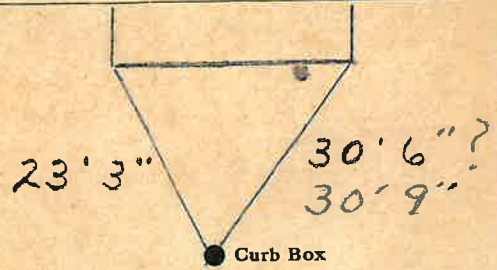

4" Main Elev. of Main at tap 4 1/2"

Gate at ● Gate at ●
 1 1/4" Copper 4'6" to main

● Curb Box

So