

LABOR AND MATERIALS

1	Copper	Connection	3/4	\$	2.87
1	Lead	Cock	3/4	\$	3.67
1	Curb	Valve	3/4	in.	
		F. S. & V.			
	Service box	Short	3 1/2 X 4 1/2		
	Old returned	Long	4 1/2 X 5 1/2		
		Buff or Rdway			
3	8"	K4 11-19-03	Copper	Pipe at	37 \$ 2.88
			G. I.		
			C. I.		
	Nipples	in. at		\$	
	Bushings	to in. at		\$	
	Red'g			\$	
	Inc'g	Coupl'gs. to in. at		\$	
	Union	in. at		\$	
	Meter	in. at		\$	
	Lead Joints	at		\$	
	Compound Joints	at		\$	
	Hrs. Water Maint. Man-1	at		\$	
3	Hrs. Water Maint. Man-2	at	1.07	\$	3.06
			91	\$	1.456
1.6	Hrs. Labor	at		\$	
	Hrs. Labor	at		\$	
	Hrs. Compressor	at		\$	
	Compensation Ins.	at \$ 2.18 per C		\$	38
	Trucking			\$	2.00
	Pay't Patch			\$	
	Pay't by <i>M. J. [unclear]</i>			\$	
	O'head			\$	29.37

46

St.

Pl.


Ave. No. 65

Name of Owner

Collins

Labor and Mat'l. Report

May 19 1947

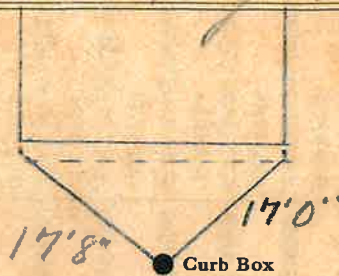

4 Main

Elev. of Main at tap 4

Gate at ●

● Gate at

3/4" Copper 3'8" to main

● Curb Box

TAX ID # 303.13-18-4