

LABOR AND MATERIALS

1	Copper	Connection	3/4	\$ 2.87	
	Lead				
1	Curb	Cock Valve T. S. & V.	3/4 in.	\$ 3.62	
	Service box	Short 3 1/2 X 4 1/2			
28 6/4	Old returned	Long 4 1/2 X 5 1/2	same	\$ —	
20	Ft.	Copper C.I.	3/4 in. Pipe at 32	\$ 6.40	
	Nipples	in. at		\$	
	Bushings	to in. at		\$	
	Red'g				
	Inc'g	Coupl'gs to in. at		\$	
	Union	in. at		\$	
	Meter	in. at		\$	
1	Lead Joints	Copper	10.00	\$ 3.21	
	Compound Joints	at		\$	
	Hrs. Water Maint. Man—1	at		\$	
5	Hrs. Water Maint. Man—2	at 10.2		\$ 5.10	
38	Hrs. Labor—	at 91		\$ 34.58	
	Hrs. Labor—	at		\$	
	Hrs. Compressor at			\$	
	Compensation Ins. at \$ 2.18	per C		\$ 8.7	
	Trucking			\$ 2.00	
	Pav't Patch			\$	
	O'head			\$	
				\$ 55.65	

52

St.
-Pl-
Ave. No. 68


Wadsworth

Name of Owner

Smith

Labor and Mat'l. Report

May 23 1949

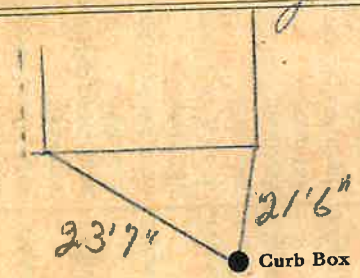

4 Main Elev. of Main at tap 5

Gate at ● ● Gate at

28'6" to MAIN

● Curb Box

TAX ID# 303.13-17-6

(To be billed)