


Labor and Materials

1	Copper	Connection	3/4"	\$ 1.48
1	Lead			
1	Curb	Cock Valve	3/4" in.	\$ 1.79
		P.S. & V.		
1	Service Box	Short	3/4" x 3/4"	\$ 1.18
	Old returned	Long	1" x 5/8"	
		Buff or Rdway		
30' 10"	Ft.	Copper	Pipe at	\$ 3.96
		Galv. Iron		
		Cast Iron		
	Nipples	in. at		\$
	Bushings	to in. at		\$
	Red'g Inc'g	Couplings to in. at		\$
	Union	in. at		\$
	Meter	in. at		\$
	Lbs. Br. Stone	at		\$
	Lbs. Sand	at		\$
	Bags Cement	at		\$
	Paving Brick	Mack Red Asphalt	at	\$
	Lead Joints	at		\$
	Leadite Joints	at		\$
2.1	Hrs. Foreman	at		\$ 13.13
	Hrs. Common Labor	at		\$
	Hrs. Common Labor	at		\$
	Hrs. Mason	at		\$
	Hrs. Mason's Helper	at		\$
	Hrs. Compressor	at		\$
	Compensation Ins.			\$.40
	Trucking			\$ 1.00
	Builders' Use of Water	Patch		\$ 5.00
Total \$				27.94

Labor and Material Report

19 22

3/4" tap at 76' 10" at

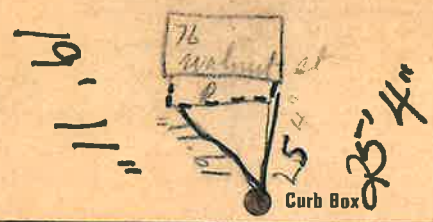

4" Main Elevation of Main at tap 6 ft

Gate at 3/4" Copper 30' 10" to Gate at

Curb Box

Old tap shut off

TAX ID# 303.13-17-10

4/11/22