

### Labor and Materials

1	Copper } Connection	3/4"	\$ 3.20
	Lead } Connection		
1	Curb } Cock Valve } T.S. & V. }	3/4" in.	\$ 1.00
	Service Box } Short 3 1/2 x 4 1/2 }		
	Old returned } Long 4 1/2 x 5 1/2 }		\$ 1.20
		Buff. or Rdway }	
4'	Ft. 3/4" in. } Copper } Galv. Iron } Cast Iron }	Pipe at 22'	\$ 15.4
	Nipples	in. at	\$
	Bushings	to in. at	\$
	Red'g } Inc'g } Couplings	to in. at	\$
	Union	in. at	\$
	Meter	in. at	\$
	Lbs. Br. Stone	at	\$
	Lbs. Sand	at	\$
	Bags Cement	at	\$
	Paving Brick } Mack } Red } Asphalt }	at	\$
	Lead Joints	at	\$
	Leadite Joints	at	\$
2	Hrs. Foreman	62.45	\$ 1.25
5	Hrs. Common Labor	50	\$ 2.50
13	Hrs. Common Labor	40.50	\$ 5.28
	Hrs. Mason		\$ 9.65
	Hrs. Mason's Helper		\$
	Hrs. Compressor		\$
	Compensation Ins.		\$ 2.5
	Trucking		\$ 10.0
	Builders' Use of Water		\$

4' OF COPPER TO MAIN


Total \$ 17.32

KH  
7-16-2003

Labor and Material Report

June 1 1911

15 Walnut St

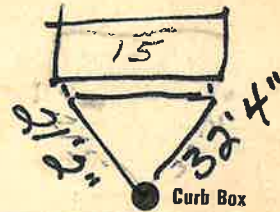

4' Main

Elev. of Main at tap 6'

Gate at

3/4" copper 4' to MAIN

Gate at

Curb Box

old taps to be dug up

TAX ID # 303.17-12-15