

Labor and Materials

1	Copper } Connection ^{3/4"}	\$ 3.20
	Lead	
1	Curb } Cock Valve } ^{3/4"} in.	\$ 1.00
	T.S. & V.	
1	Service Box } Short 3 1/2 x 4 1/2	\$ 1.40
29	Old returned } Long 4 1/2 x 5 1/2	
		Buff. or Rdway
29	Ft. ^{3/4"} in. } Copper } Pipe at.	\$ 20.9
		Galv. Iron
		Cast Iron
	Nipples..... in. at.....	\$
1	Bushings ^{3/8"} to ^{1/2"} in. at.....	\$ 15
1	Red } Couplings ^{Brass} in. at.....	\$ 10
	Inc. }	
	Union..... in. at.....	\$
	Meter..... in. at.....	\$
	Lbs. Br. Stone at.....	\$
	Lbs. Sand at.....	\$
	Bags Cement at.....	\$
	Paving Brick } Mack } at.....	\$
		Red
		Asphalt
	Lead Joints at.....	\$
	Leadite Joints at.....	\$
7	Hrs. Foreman at..... ^{6 1/2 hr}	\$ 438
30	Hrs. Common Labor at..... ^{20 1/2 hr}	\$ 14.63
	Hrs. Common Labor at.....	\$
	Hrs. Mason at.....	\$
	Hrs. Mason's Helper at.....	\$
	Hrs. Compressor at.....	\$
	Compensation Ins.....	\$ 50
	Trucking.....	\$ 1.00
	Builders' Use of Water.....	\$

29 FT OF 3/4" COPPER


KH 7-15-2003

Total \$ 28.45

28-61 16 A-B

Labor and Material Report June 27 1928

3/4" tap at 14 1/2' to Walnut st

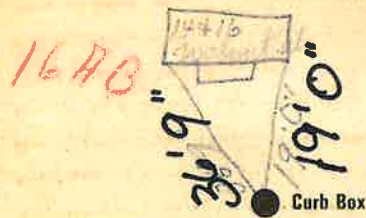

4" Main

Elev. of Main at tap 6 ft

Gate at 3/4" Copper 29' to MAIN Gate at

● Curb Box

Old tap shut off

TAX ID # 303.17-11-4