

LABOR AND MATERIALS

1	Copper Lead	Connection	$3/4$	\$	1.35
1	Curb	Cock Valve T.S. & V.	$3/4$ in.	\$	1.80
1	Service Box Old returned	Short $3\frac{1}{2} \times 4\frac{1}{2}$		\$	1.80
		Long $4\frac{1}{2} \times 5\frac{1}{2}$			
		Buff or Rdway			
1	Ft.	$3/4$ in.	Copper Galv Iron Cast Iron Pipe at	\$	4.97
	Nipples	in. at		\$	
	Bushings	to in. at		\$	
	Red'g Inc'g	Couplings to in. at		\$	
	Union	in. at		\$	
	Meter	in. at		\$	
	Lead Joints at			\$	
	Leadite Joints at			\$	
	Hrs. Foreman at			\$	
9	Hrs. Chauffeur at			\$	6.19
	Hrs. Tapper at			\$	
2	Hrs. Labor at			\$	44.00
	Hrs. Labor at			\$	
	Hrs. Compressor at			\$	
	Compensation Ins.	2,213		\$	1.23
	Trucking			\$	
	Builders Use of Water			\$	3.85
	Tapp Miller			\$	
				\$	
				\$	
	29'6" of COPPER TO MAIN.			\$	27.61

KA 7-16-2003

2-43

St. ~~Pl.~~ Ave. No. 18


Walnut

Name of Owner

Copezutti

Labor and Mat'l. Report

Apr 17 1943

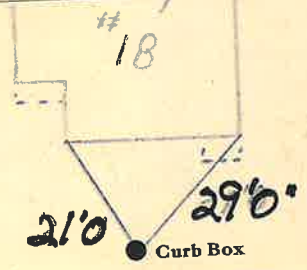

4" Main

Elev. of Main at tap 5 1/2'

Gate at

Gate at

3/4" COPPER 29'6" TO MAIN

Curb Box

TAX ID # 303.17-11-5